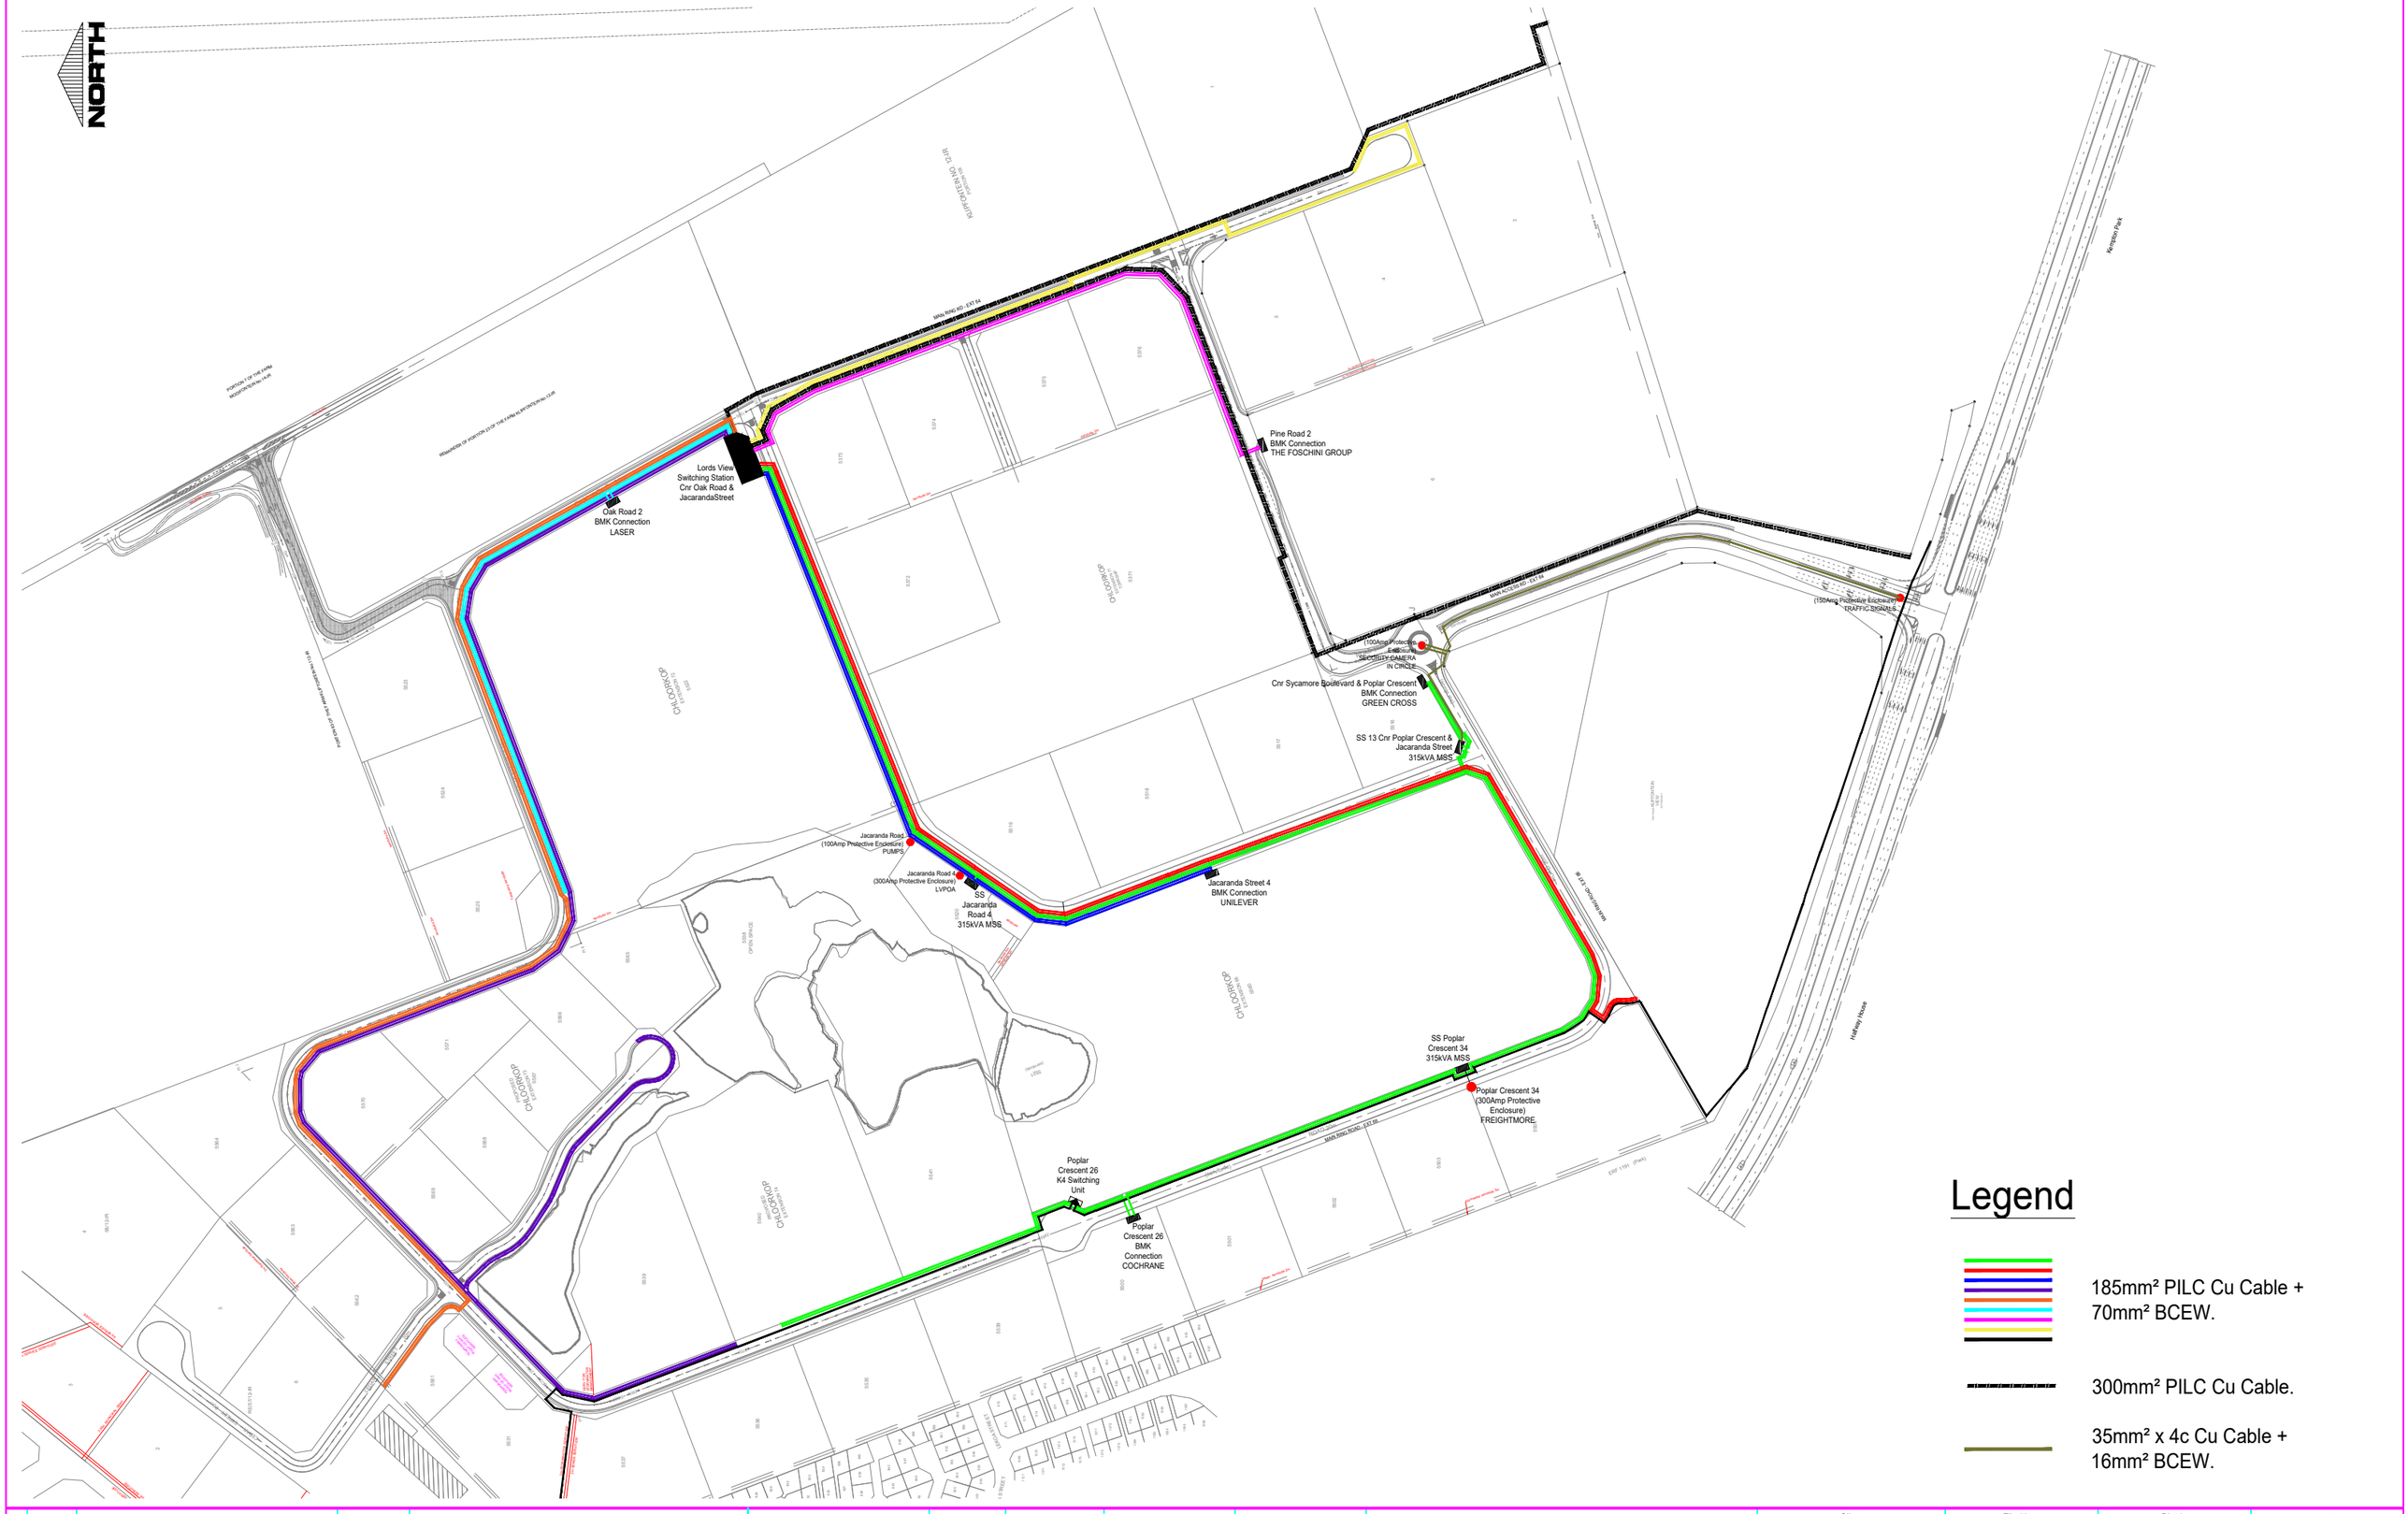

Legend

- 185mm² PILC Cu Cable + 70mm² BCEW.
- 300mm² PILC Cu Cable.
- 35mm² x 4c Cu Cable + 16mm² BCEW.

No.	Date	Amendments	Sign
Z	2017-05-11	Record Drawing	

TOPACK CONSULTING
ELECTRICAL ENGINEERS
249 LIZJOHN STREET
LYNNWOOD RIDGE
PRETORIA

Designed by	F.NEL
Checked by	T.VAN GRAAN
Drawn by	F.NEL
Checked By	

Note :
Unless this Drawing has been signed by a Registered Professional it is issued for information only.

Design Approved
for Consulting Engineer
Date

Approved by
for Client
Date

LORDS VIEW INDUSTRIAL PARK

Electrical Reticulation Medium Voltage Layout

Client	File No.	District	Type of Design
Lords Trust	120617	Ekurhuleni	Electrical
	Scale 1:2500	Area Chloorkop	Drawing No. 120617-700-01 Rev. Z